

1


2

3

4


PRODUCT NUMBER  
XXXXX-YYY HTLF

- LEAD FREE OPTION  
SEE NOTE 1,8
- TUBE PACKAGING OPTION  
SEE NOTE 1
- HIGH TEMPERATURE PLASTIC  
SEE NOTE 1
- NO OF POSITIONS  
SEE NOTE 1
- PIN PLATING  
SEE SHEET 2
- BASE PART NO.

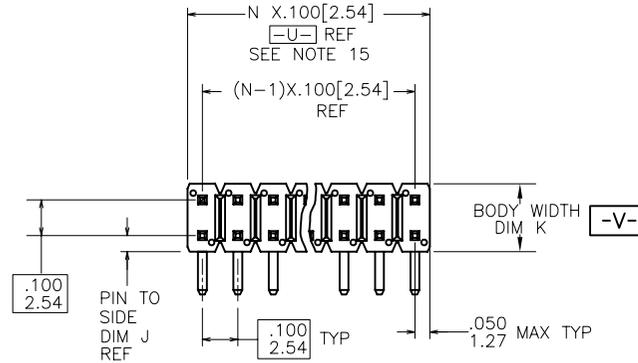

TOP VIEW

⊕ ∅ .020/.51 (M) U (M) V W  
NOTE 4

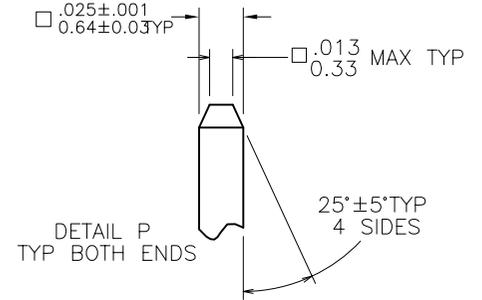

A


A

B


B

68020-X XX-XXX XXX LF

- TAIL LENGTH (EXAMPLE BELOW)  
3.0mm=030 12.8mm=128 (SEE NOTE 11 & 12)
- MATING LENGTH (EXAMPLE BELOW)  
5.0mm=050 25.5mm=255 (SEE NOTE 11 & 12)
- TOTAL NUMBER OF POSITION  
FROM 2(2X1) THRU 72 (2X36) POSITIONS
- PIN PLATING (SEE NOTE 9)  
1=0.76µm Au  
4= PURE TIN  
8=0.36µm Au
- BASE PART NO.

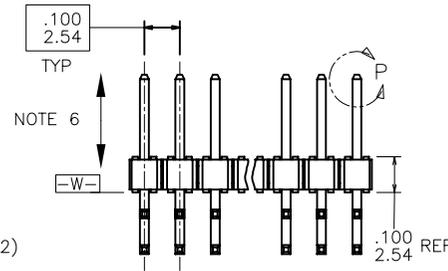

SIDE VIEW

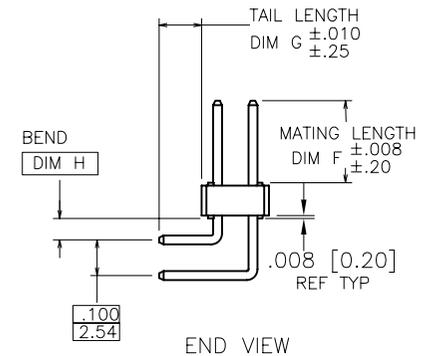

END VIEW

C

C

Copyright FCI.

D

D

REV F - 2006-04-17

1

2

3

4

| rev | ecn no      | dr  | date       |
|-----|-------------|-----|------------|
| BK  | ELX-N-16105 | ZK  | 2013-10-22 |
| BL  | ELX-N-19718 | JH  | 2014-12-11 |
| BM  | ELX-N-20595 | JH  | 2015-03-30 |
| BG  | M08-0331    | MHT | 12/01/08   |
| BH  | M09-0105    | MHT | 7/10/09    |
| BJ  | N11-0118    | JZ  | 2011-04-12 |

|                                       |             |          |                                                 |                                   |                        |              |
|---------------------------------------|-------------|----------|-------------------------------------------------|-----------------------------------|------------------------|--------------|
| www.fciconnect.com                    |             |          | surface 6.4<br>ISO 1302                         | tolerance std<br>ISO 406 ISO 1101 | projection<br>ISO 1101 | INCH/MM      |
| TOLERANCES UNLESS OTHERWISE SPECIFIED |             |          | ANGULAR                                         | LINEAR                            | size A4                | Scale 1.000  |
| Dr                                    | D.WIHTING   | 03/08/93 | 0.X                                             | ±0.3                              | ECN                    |              |
| Eng                                   | T.HANNA     | 03/08/93 | 0.XX                                            | ±0.15                             | Product family         | BERGSTIK     |
| Chr                                   | T.BREWNAKER | 03/08/93 | 0.XXX                                           | ±0.05                             | Spec ref               |              |
| Appr                                  | T.HANNA     | 03/08/93 | Product family BERGSTIK                         |                                   | Spec ref               |              |
| FCI                                   |             |          | title BERGSTIK® II HEADER<br>.100/2.54cc DR R/A |                                   | dwg no 68020           | Rev. BM      |
|                                       |             |          | catalog no                                      |                                   | Product-Customer Drw   | sheet 1 of 5 |

PIN PLATING CODES:

|             |                                                         |
|-------------|---------------------------------------------------------|
| XXXX-1YY    | 30u"/0.76u MIN (SEE NOTE 9) OVER 50u"/1.27u MIN Ni      |
| XXXX-2YY    | 15u"/0.38u MIN (SEE NOTE 9) OVER 50u"/1.27u MIN Ni      |
| XXXX-3YY    | 50u"/1.27u MIN (SEE NOTE 9) OVER 50u"/1.27u MIN Ni      |
| XXXX-4YY    | 100u"/2.54u MIN Sn OVER 50u"/1.27u MIN Ni (SEE NOTE 10) |
| XXXX-4YYHLF |                                                         |
| XXXX-5YY    | 15u"/0.38u MIN (SEE NOTE 9) OVER 50u"/1.27u MIN Ni      |
| XXXX-6YY    | 30u"/0.76u MIN (SEE NOTE 9) OVER 50u"/1.27u MIN Ni      |
| XXXX-7YY    | 30u"/0.76u MIN (SEE NOTE 9) OVER 50u"/1.27u MIN Ni      |
| XXXX-8YY    | 15u"/0.38u MIN (SEE NOTE 9) OVER 50u"/1.27u MIN Ni      |
| XXXX-9YY    | 15u"/0.38u MIN (SEE NOTE 9) OVER 50u"/1.27u MIN Ni      |
| XXXX-0YY    | 30u"/0.76u MIN (SEE NOTE 9) OVER 50u"/1.27u MIN Ni      |

NOTES

1. PART NUMBER OPTIONS:

PIN PLATING CODES (SEE ABOVE)

HIGH TEMP. MATERIAL:

PART NUMBERS WITH AND WITHOUT "H" WILL BE SUPPLIED WITH HIGH TEMPERATURE PLASTIC

NUMBER OF POSITION:

EVEN NUMBER OF POSITIONS FROM 2 (2X1) THRU 72 (2X36).

PACKAGING:

PACKAGED IN POLY BAGS.

EIGHT DIGIT PART NUMBERS FOLLOWED BY A "T" ARE PACKAGED IN TUBES. SEE SPECIFIC PART NUMBERS FOR AVAILABILITY.

LEAD FREE:

ADD "HLF" SUFFIX AT THE END OF PART NUMBER FOR LEAD FREE OPTION, NOT AVAILABLE FOR -5YY,-5YYH,-6YY & -6YYH.

2. BODY MATERIAL:

MANUFACTURER'S OPTION OF NYLON, PCT GLASS FIBER REINFORCED, OR MINERAL FILLED LCP FLAME RETARDANT PER UL-94V-0. COLOR: BLACK.

PART NUMBERS WITH AND WITHOUT "H" SUFFIX WILL WITHSTAND EXPOSURE TO 260°C PEAK TEMPERATURE FOR 20 SECONDS IN WAVE SOLDER, INFRA-RED OR VAPOR PHASE SOLDER PROCESS.

3. PIN MATERIAL: PHOS-BRONZE.


4. MEASURED WITH PART IN RESTRAINED CONDITION.

5. TWO SIDES OF PIN TIPS NOT PLATED. TYPICAL BOTH ENDS.

6. 2LBS/0.9KG MIN PIN RETENTION IN EITHER DIRECTION.

7. MILITARY BERGSTIK HEADER  
P/N XXXX-XY-MIL  
NOT AVAILABLE.

- 8. THESE PRODUCTS MEETS EUROPEAN UNION DIRECTIVES AND OTHER COUNTRY REGULATION AS DESCRIBED IN GS-22-008.
- 9. PLATING OPTIONS:  
PERFORMANCE PLATING WILL BE EITHER GOLD OR GXT ON POST OR TAIL, OPTIONALLY (78~295u"/~2~7.5u) TIN ON TAIL.
- 10. THIS PRODUCT HAS 100% TIN PLATING IN THE INTERFACE AND HAS NOT BEEN TESTED FOR WHISKER GROWTH IN ALL INTERCONNECT ENVIRONMENTS."
- 11. THE OAL DON'T EXCEED 31mm  
OAL= MATTING DIM + TAIL DIM +4.0mm<=31mm \*WHERE THE SUM OF TAIL LEGTH DON'T EXCEED 27mm\* TAIL  
TAIL LENGTH MIN 2.00mm TAIL LENGTH MAX 10.4mm  
MATTING LENGTH MIN 1.5mm MATTING LENGTH MAX 25.4mm
- 12. INCREMENTS BY 0.1mm IN LENGTH ONLY
- 13. FOR ESPECIAL PACKAGING REQUEST PLEASE CONTACT PRODUCT MANAGER FOR AVAILABILITY
- 14. BEND DIMENSION AT 1.5mm ONLY
- 15. TO DETERMINE DIMENSIONS:  
N=NUMBER OF POSITION PER ROW  
EXAMPLE: 10 PDS. N X .100/2.54

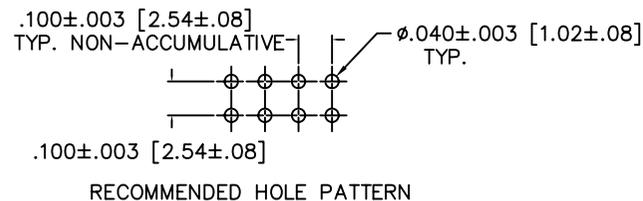

RECOMMENDED HOLE PATTERN



Copyright FCI.

|                    |             |                     |                                       |                                   |                  |              |
|--------------------|-------------|---------------------|---------------------------------------|-----------------------------------|------------------|--------------|
| www.fciconnect.com |             |                     | surface<br>ISO 1302 ✓                 | tolerance std<br>ISO 406 ISO 1101 | projection<br>A4 | INCH/MM      |
|                    |             |                     | TOLERANCES UNLESS OTHERWISE SPECIFIED |                                   | size             | Scale        |
| Dr                 | D.WIHTING   | 03/08/93            | ANGULAR                               | 0.X ±0.3                          | A4               | 1.000        |
| Eng                | T.HANNA     | 03/08/93            | LINEAR                                | 0.XX ±0.15                        |                  |              |
| Chr                | T.BREWNAKER | 03/08/93            | 0° ±2°                                | 0.XXX ±0.05                       | ECN              |              |
| Appr               | T.HANNA     | 03/08/93            | Product family                        | BERGSTIK                          | Spec ref         |              |
| FCI                |             | title               |                                       | 68020                             |                  | Rev.         |
|                    |             | BERGSTIK® II HEADER |                                       |                                   |                  | BM           |
|                    |             | .100/2.54cc DR R/A  |                                       |                                   |                  |              |
|                    |             | catalog no          |                                       | Product-Customer Drw              |                  | sheet 2 of 5 |

1

2

3

4

|           | PRODUCT NUMBER        |                  | MATING LENGTH    |                  | TAIL LENGTH     |                  | BEND DIM.       |                  | PIN TO SIDE     |                  | BODY WIDTH      |                      | PACKAGING | LF OPTION |
|-----------|-----------------------|------------------|------------------|------------------|-----------------|------------------|-----------------|------------------|-----------------|------------------|-----------------|----------------------|-----------|-----------|
|           | DIM F                 | DIM F            | DIM G            | DIM G            | DIM H           | DIM H            | DIM J           | DIM J            | DIM K           | DIM K            |                 |                      |           |           |
|           | ENGLISH               | METRIC           | ENGLISH          | METRIC           | ENGLISH         | METRIC           | ENGLISH         | METRIC           | ENGLISH         | METRIC           |                 |                      |           |           |
| A         | 68020-YYY             | 0.230            | 5.84             | 0.095            | 2.41            | 0.060            | 1.52            | 0.045            | 1.14            | 0.190            | 4.83            | POLY BAGS/TUBES      | NOTE 1,8  |           |
|           | 68021-YYY             | 0.230            | 5.84             | 0.120            | 3.05            | 0.060            | 1.52            | 0.045            | 1.14            | 0.190            | 4.83            | POLY BAGS            |           |           |
|           | 68022-YYY             | 0.318            | 8.08             | 0.110            | 2.79            | 0.060            | 1.52            | 0.070            | 1.78            | 0.240            | 6.10            | POLY BAGS            |           |           |
|           | 68025-YYY             | 0.230            | 5.84             | 0.195            | 4.95            | 0.060            | 1.52            | 0.045            | 1.14            | 0.190            | 4.83            | POLY BAGS            |           |           |
|           | 68405-YYY             | 0.230            | 5.84             | 0.095            | 2.41            | 0.060            | 1.52            | 0.070            | 1.78            | 0.240            | 6.10            | POLY BAGS            |           |           |
|           | <del>68452-YYY</del>  | <del>0.380</del> | <del>9.65</del>  | <del>0.110</del> | <del>2.79</del> | <del>0.060</del> | <del>1.52</del> | <del>0.070</del> | <del>1.78</del> | <del>0.240</del> | <del>6.10</del> | <del>POLY BAGS</del> |           |           |
|           | 68459-YYY             | 0.318            | 8.08             | 0.150            | 3.81            | 0.060            | 1.52            | 0.070            | 1.78            | 0.240            | 6.10            | POLY BAGS/TUBES      |           |           |
|           | <del>68462-YYY</del>  | <del>0.400</del> | <del>10.16</del> | <del>0.120</del> | <del>3.05</del> | <del>0.060</del> | <del>1.52</del> | <del>0.045</del> | <del>1.14</del> | <del>0.190</del> | <del>4.83</del> | <del>POLY BAGS</del> |           |           |
|           | <del>68463-YYY</del>  | <del>0.230</del> | <del>5.84</del>  | <del>0.110</del> | <del>2.79</del> | <del>0.060</del> | <del>1.52</del> | <del>0.070</del> | <del>1.78</del> | <del>0.240</del> | <del>6.10</del> | <del>POLY BAGS</del> |           |           |
|           | 68480-YYY             | 0.318            | 8.08             | 0.110            | 2.79            | 0.060            | 1.52            | 0.045            | 1.14            | 0.190            | 4.83            | POLY BAGS            |           |           |
| 68492-YYY | 0.230                 | 5.84             | 0.150            | 3.81             | 0.060           | 1.52             | 0.070           | 1.78             | 0.240           | 6.10             | POLY BAGS       |                      |           |           |
| 68493-YYY |                       |                  |                  | UNAVAILABLE      |                 |                  |                 |                  |                 |                  |                 |                      |           |           |
| B         | 68695-YYY             | 0.230            | 5.84             | 0.090            | 2.29            | 0.060            | 1.52            | 0.045            | 1.14            | 0.190            | 4.83            | POLY BAGS            | NOTE 1,8  |           |
|           | <del>68696-YYY</del>  | <del>0.318</del> | <del>8.08</del>  | <del>0.125</del> | <del>3.18</del> | <del>0.060</del> | <del>1.52</del> | <del>0.045</del> | <del>1.14</del> | <del>0.190</del> | <del>4.83</del> | <del>POLY BAGS</del> |           |           |
|           | 68697-YYY             | 0.230            | 5.84             | 0.125            | 3.18            | 0.060            | 1.52            | 0.045            | 1.14            | 0.190            | 4.83            | POLY BAGS            |           |           |
|           | 68715-YYY             | 0.138            | 3.51             | 0.138            | 3.51            | 0.060            | 1.52            | 0.045            | 1.14            | 0.190            | 4.83            | POLY BAGS            |           |           |
|           | 68728-YYY             |                  |                  |                  | UNAVAILABLE     |                  |                 |                  |                 |                  |                 |                      |           |           |
|           | <del>68740-YYY</del>  | <del>0.345</del> | <del>8.76</del>  | <del>0.110</del> | <del>2.79</del> | <del>0.060</del> | <del>1.52</del> | <del>0.070</del> | <del>1.78</del> | <del>0.240</del> | <del>6.10</del> | <del>POLY BAGS</del> |           |           |
|           | <del>68759-YYY</del>  | <del>0.275</del> | <del>6.99</del>  | <del>0.120</del> | <del>3.05</del> | <del>0.060</del> | <del>1.52</del> | <del>0.045</del> | <del>1.14</del> | <del>0.190</del> | <del>4.83</del> | <del>POLY BAGS</del> |           |           |
|           | <del>68780-YYY</del>  | <del>0.230</del> | <del>5.84</del>  | <del>0.039</del> | <del>0.99</del> | <del>0.060</del> | <del>1.52</del> | <del>0.045</del> | <del>1.14</del> | <del>0.190</del> | <del>4.83</del> | <del>POLY BAGS</del> |           |           |
|           | <del>69147-YYY</del>  | <del>0.540</del> | <del>13.72</del> | <del>0.260</del> | <del>6.60</del> | <del>0.060</del> | <del>1.52</del> | <del>0.045</del> | <del>1.14</del> | <del>0.190</del> | <del>4.83</del> | <del>POLY BAGS</del> |           |           |
|           | 69186-YYY             |                  |                  |                  | UNAVAILABLE     |                  |                 |                  |                 |                  |                 |                      |           |           |
| C         | <del>72240-YYYH</del> | <del>0.550</del> | <del>13.97</del> | <del>0.120</del> | <del>3.05</del> | <del>0.060</del> | <del>1.52</del> | <del>0.070</del> | <del>1.78</del> | <del>0.240</del> | <del>6.10</del> | <del>POLY BAGS</del> |           |           |
|           | <del>72261-YYYH</del> | <del>0.100</del> | <del>2.54</del>  | <del>0.100</del> | <del>2.54</del> | <del>0.060</del> | <del>1.52</del> | <del>0.045</del> | <del>1.14</del> | <del>0.190</del> | <del>4.83</del> | <del>POLY BAGS</del> |           |           |
|           | <del>72324-YYYH</del> | <del>0.550</del> | <del>13.97</del> | <del>0.260</del> | <del>6.60</del> | <del>0.060</del> | <del>1.52</del> | <del>0.070</del> | <del>1.78</del> | <del>0.240</del> | <del>6.10</del> | <del>POLY BAGS</del> |           |           |
|           | <del>72410-YYYH</del> | <del>0.120</del> | <del>3.05</del>  | <del>0.350</del> | <del>8.89</del> | <del>0.120</del> | <del>3.05</del> | <del>0.070</del> | <del>1.78</del> | <del>0.240</del> | <del>6.10</del> | <del>POLY BAGS</del> |           |           |
|           | <del>74430-YYYH</del> | <del>0.000</del> | <del>0.00</del>  | <del>0.233</del> | <del>5.92</del> | <del>0.060</del> | <del>1.52</del> | <del>0.045</del> | <del>1.14</del> | <del>0.190</del> | <del>4.83</del> | <del>POLY BAGS</del> |           |           |



Copyright FCI.

|                    |             |          |                                                    |                                   |                      |                |
|--------------------|-------------|----------|----------------------------------------------------|-----------------------------------|----------------------|----------------|
| www.fciconnect.com |             |          | surface<br>ISO 1302 ✓                              | tolerance std<br>ISO 406 ISO 1101 | projection<br>       | INCH/MM<br>↔   |
|                    |             |          | TOLERANCES UNLESS OTHERWISE SPECIFIED              |                                   |                      | Scale<br>1.000 |
| Dr                 | D.WIHTING   | 03/08/93 | ANGULAR                                            | LINEAR                            | size<br>A4           |                |
| Eng                | T.HANNA     | 03/08/93 | 0°                                                 | ±2°                               | ECN                  |                |
| Chr                | T.BREWNAKER | 03/08/93 | Product family BERGSTIK                            |                                   | Spec ref             |                |
| Appr               | T.HANNA     | 03/08/93 | title<br>BERGSTIK® II HEADER<br>.100/2.54cc DR R/A |                                   | dwg no<br>68020      | Rev.<br>BM     |
| catalog no         |             |          |                                                    |                                   | Product-Customer Drw | sheet 3 of 5   |

1

2

3

4

1

2

3

4

| PRODUCT NUMBER | MATING LENGTH |        | TAIL LENGTH |        | BEND DIM. |        | PIN TO SIDE |        | BODY WIDTH |        | PACKAGING       | LF OPTION |
|----------------|---------------|--------|-------------|--------|-----------|--------|-------------|--------|------------|--------|-----------------|-----------|
|                | DIM F         | DIM F  | DIM G       | DIM G  | DIM H     | DIM H  | DIM J       | DIM J  | DIM K      | DIM K  |                 |           |
|                | ENGLISH       | METRIC | ENGLISH     | METRIC | ENGLISH   | METRIC | ENGLISH     | METRIC | ENGLISH    | METRIC |                 |           |
| 78576-XXX      | 0.120         | 3.05   | 0.120       | 3.05   | 0.060     | 1.52   | 0.070       | 1.78   | 0.240      | 6.10   | -POLY BAGS      | OB        |
| 78923-XXX      | 0.240         | 6.10   | 0.095       | 2.41   | 0.060     | 1.52   | 0.070       | 1.78   | 0.240      | 6.10   | -POLY BAGS      | OB        |
| 78951-XXX      | 0.500         | 12.70  | 0.120       | 3.05   | 0.060     | 1.52   | 0.045       | 1.14   | 0.190      | 4.83   | -POLY BAGS      | OB        |
| 79200-XXX      | 0.155         | 3.94   | 0.280       | 7.11   | 0.060     | 1.52   | 0.070       | 1.78   | 0.240      | 6.10   | -POLY BAGS      | OB        |
| 79201-XXX      | 0.225         | 5.72   | 0.280       | 7.11   | 0.060     | 1.52   | 0.070       | 1.78   | 0.240      | 6.10   | -POLY BAGS      | OB        |
| 79202-XXX      | 0.245         | 6.22   | 0.280       | 7.11   | 0.060     | 1.52   | 0.070       | 1.78   | 0.240      | 6.10   | -POLY BAGS      | OB        |
| 79203-XXX      | 0.315         | 8.00   | 0.280       | 7.11   | 0.060     | 1.52   | 0.070       | 1.78   | 0.240      | 6.10   | -POLY BAGS      | OB        |
| 79204-XXX      | 0.177         | 4.50   | 0.410       | 10.41  | 0.060     | 1.52   | 0.070       | 1.78   | 0.240      | 6.10   | -POLY BAGS      | OB        |
| 79205-XXX      | 0.25          | 6.35   | 0.410       | 10.41  | 0.060     | 1.52   | 0.070       | 1.78   | 0.240      | 6.10   | -POLY BAGS      | OB        |
| 79206-XXX      | 0.315         | 8.00   | 0.410       | 10.41  | 0.060     | 1.52   | 0.070       | 1.78   | 0.240      | 6.10   | -POLY BAGS      | OB        |
| 79248-XXX      |               |        |             |        |           |        |             |        |            |        |                 | NOTE 1,8  |
| 79257-XXX      | 0.230         | 5.84   | 0.120       | 3.05   | 0.060     | 1.52   | 0.070       | 1.78   | 0.240      | 6.10   | POLY BAGS/TUBES |           |
| 79258-XXX      | 0.318         | 8.08   | 0.120       | 3.05   | 0.060     | 1.52   | 0.070       | 1.78   | 0.240      | 6.10   | POLY BAGS/TUBES |           |
| 79807-XXX      |               |        |             |        |           |        |             |        |            |        |                 |           |
| 79841-XXX      | 0.060         | 1.52   | 0.230       | 5.84   | 0.060     | 1.52   | 0.045       | 1.14   | 0.190      | 4.83   | -POLY BAGS      | OB        |
| 86385-XXX      | 0.260         | 6.6    | 0.120       | 3.05   | 0.060     | 1.52   | 0.070       | 1.78   | 0.240      | 6.10   | -POLY BAGS      | OB        |
| 86840-XXX      | 0.318         | 8.08   | 0.230       | 5.84   | 0.060     | 1.52   | 0.070       | 1.78   | 0.240      | 6.10   | POLY BAGS       |           |
| 86867-XXX      |               |        |             |        |           |        |             |        |            |        |                 |           |
| 88822-XXX      | 0.318         | 8.08   | 0.080       | 2.03   | 0.060     | 1.52   | 0.070       | 1.78   | 0.240      | 6.10   | -POLY BAGS      | OB        |
| 89292-XXX      | 0.120         | 3.05   | 0.300       | 7.62   | 0.120     | 3.05   | 0.045       | 1.14   | 0.190      | 4.83   | -POLY BAGS      | OB        |
| 90234-XXX      | 0.130         | 3.30   | 0.195       | 4.95   | 0.060     | 1.52   | 0.045       | 1.14   | 0.190      | 4.83   | -POLY BAGS      | OB        |
| 92634-XXX      | 0.318         | 8.08   | 0.318       | 8.08   | 0.060     | 1.52   | 0.045       | 1.14   | 0.190      | 4.83   | POLY BAGS       |           |
| 93162-XXX      | 0.230         | 5.84   | 0.400       | 10.16  | 0.150     | 3.81   | 0.045       | 1.14   | 0.190      | 4.83   | -POLY BAGS      | OB        |
| 93932-XXX      | 0.200         | 5.08   | 0.120       | 3.05   | 0.060     | 1.52   | 0.070       | 1.78   | 0.240      | 6.10   | -POLY BAGS      | OB        |
| 93939-XXX      | 0.160         | 4.06   | 0.120       | 3.05   | 0.060     | 1.52   | 0.070       | 1.78   | 0.240      | 6.10   | POLY BAGS       | NOTE 1,8  |
| 94687-XXX      | 0.430         | 10.92  | 0.230       | 5.84   | 0.060     | 1.52   | 0.045       | 1.14   | 0.190      | 4.83   | -POLY BAGS      | OB        |
| 94688-XXX      | 0.385         | 9.78   | 0.280       | 7.11   | 0.060     | 1.52   | 0.070       | 1.78   | 0.240      | 6.10   | -POLY BAGS      | OB        |

A

A

B

B

C

C



Copyright FCI.

D

D

|                    |                                                    |          |                                       |                                  |                                       |                |
|--------------------|----------------------------------------------------|----------|---------------------------------------|----------------------------------|---------------------------------------|----------------|
| www.fciconnect.com |                                                    |          | surface<br>ISD 1302 ✓                 | tolerance std<br>ISD 406 ISD 110 | projection<br>                        | INCH/MM<br>↔   |
|                    |                                                    |          | TOLERANCES UNLESS OTHERWISE SPECIFIED |                                  |                                       | Scale<br>1.000 |
| Dr                 | D.WIHTING                                          | 03/08/93 | ANGULAR                               | LINEAR                           | 0.X ±0.3<br>0.XX ±0.15<br>0.XXX ±0.05 | size<br>A4     |
| Eng                | T.HANNA                                            | 03/08/93 | 0° ±2°                                |                                  |                                       | ECN            |
| Chr                | T.BREWNAKER                                        | 03/08/93 |                                       |                                  |                                       |                |
| Appr               | T.HANNA                                            | 03/08/93 | Product family                        | BERGSTIK                         | Spec ref                              |                |
|                    | title<br>BERGSTIK® II HEADER<br>.100/2.54cc DR R/A |          | eng n°<br>68020                       |                                  | Rev.<br>BM                            |                |
| catalog no         |                                                    |          | Product-Customer Drw                  |                                  | sheet 4 of 5                          |                |

1

2

3

4

| PRODUCT NUMBER       | MATING LENGTH    |                  | TAIL LENGTH      |                  | BEND DIM.        |                 | PIN TO SIDE      |                 | BODY WIDTH       |                 | PACKAGING             | LF OPTION |
|----------------------|------------------|------------------|------------------|------------------|------------------|-----------------|------------------|-----------------|------------------|-----------------|-----------------------|-----------|
|                      | DIM F            | DIM F            | DIM G            | DIM G            | DIM H            | DIM H           | DIM J            | DIM J           | DIM K            | DIM K           |                       |           |
|                      | ENGLISH          | METRIC           | ENGLISH          | METRIC           | ENGLISH          | METRIC          | ENGLISH          | METRIC          | ENGLISH          | METRIC          |                       |           |
| <del>95035-XYH</del> | <del>0.230</del> | <del>5.84</del>  | <del>0.400</del> | <del>10.16</del> | <del>0.060</del> | <del>1.52</del> | <del>0.045</del> | <del>1.14</del> | <del>0.190</del> | <del>4.83</del> | <del>-POLY BAGS</del> | OB        |
| <del>95182-XYH</del> | <del>0.400</del> | <del>10.16</del> | <del>0.110</del> | <del>2.79</del>  | <del>0.060</del> | <del>1.52</del> | <del>0.070</del> | <del>1.78</del> | <del>0.240</del> | <del>6.10</del> | <del>-POLY BAGS</del> | OB NOTE   |
| <del>98358-XYH</del> | <del>0.205</del> | <del>5.21</del>  | <del>0.410</del> | <del>10.41</del> | <del>0.060</del> | <del>1.52</del> | <del>0.070</del> | <del>1.78</del> | <del>0.240</del> | <del>6.10</del> | <del>-POLY BAGS</del> | OB 1,8    |
| <del>98359-XYH</del> | <del>0.275</del> | <del>6.99</del>  | <del>0.410</del> | <del>10.41</del> | <del>0.060</del> | <del>1.52</del> | <del>0.070</del> | <del>1.78</del> | <del>0.240</del> | <del>6.10</del> | <del>-POLY BAGS</del> | OB        |
| 68020-144-095030LF   | .374             | 9.50             | 0.118            | 3.00             | 0.060            | 1.52            | 0.070            | 1.78            | 0.240            | 6.10            | POLY BAGS             |           |



Copyright FCI.

|                                       |             |          |                                                         |                                   |                      |                |
|---------------------------------------|-------------|----------|---------------------------------------------------------|-----------------------------------|----------------------|----------------|
| www.fciconnect.com                    |             |          | surface<br>ISO 1302 <input checked="" type="checkbox"/> | tolerance std<br>ISO 406 ISO 1101 | projection<br>       | INCH/MM<br>    |
| TOLERANCES UNLESS OTHERWISE SPECIFIED |             |          | ANGULAR                                                 | LINEAR                            | size<br>A4           | Scale<br>1.000 |
| Dr                                    | D.WIHTING   | 03/08/93 | 0.X                                                     | ±0.3                              | ECN                  |                |
| Eng                                   | T.HANNA     | 03/08/93 | 0.XX                                                    | ±0.15                             | ECN                  |                |
| Chr                                   | T.BREWNAKER | 03/08/93 | 0.XXX                                                   | ±0.05                             | ECN                  |                |
| Appr                                  | T.HANNA     | 03/08/93 | Product family BERGSTIK                                 |                                   | Spec ref             |                |
|                                       |             |          | title<br>BERGSTIK® II HEADER<br>.100/2.54cc DR R/A      |                                   | dwg no<br>68020      | Rev.<br>BM     |
|                                       |             |          | catalog no                                              |                                   | Product-Customer Drw | sheet 5 of 5   |

# Mouser Electronics

Authorized Distributor

Click to View Pricing, Inventory, Delivery & Lifecycle Information:

## [FCI / Amphenol:](#)

[68020-572](#) [68021-116](#) [68021-140](#) [68405-272](#) [68405-472](#) [79257-220](#) [68697-272](#) [68020-104H](#) [68020-210H](#)  
[68020-572H](#) [68020-622H](#) [68020-672H](#) [68021-110](#) [68021-128H](#) [68021-130H](#) [68021-172H](#) [68021-272H](#) [68021-472H](#) [68021-572H](#) [68022-572](#) [68022-604](#) [68022-606](#) [68405-102H](#) [68405-130H](#) [68405-134](#) [68405-172H](#) [68405-272H](#) [68405-472H](#) [68405-524H](#) [68405-572H](#) [68452-172](#) [68452-272](#) [68459-140](#) [68459-272](#) [68459-472](#) [68462-472](#)  
[68463-102H](#) [68463-172](#) [68463-650](#) [68480-472](#) [68492-272](#) [68695-172](#) [68695-272H](#) [68695-472H](#) [68697-172](#) [68740-172](#) [68740-472H](#) [68759-272](#) [68020-172](#) [68020-472](#) [68020-672](#) [68020-272H](#) [68020-272](#) [78576-236H](#) [78923-210H](#) [79201-172H](#) [79202-172H](#) [79257-226H](#) [79257-372](#) [79257-572](#) [79258-172](#) [79258-272](#) [79258-672](#) [68021-704HLF](#) [79257-250HLF](#) [79257-272H](#) [79257-372HLF](#) [79257-472H](#) [68022-212HLF](#) [68492-172H](#) [68492-272HLF](#) [68715-472H](#) [68020-402](#) [68020-408H](#) [68021-102H](#) [68021-136](#) [68021-410](#) [68021-414H](#) [68021-540H](#) [68021-604](#) [68021-614](#) [68021-620](#) [68022-106H](#) [68022-116](#) [68022-116H](#) [68022-120H](#) [68022-124H](#) [68022-264H](#) [68022-612](#) [68025-126](#) [68025-534H](#) [68405-250](#) [68405-420H](#) [68405-504](#) [86840-172H](#) [90234-472](#) [92634-172](#) [92634-572](#) [68022-272HLF](#) [68022-372HLF](#)