

THIS DRAWING IS UNPUBLISHED.






RELEASED FOR PUBLICATION

ALL RIGHTS RESERVED.

© COPYRIGHT - By -

REVISIONS

| P | LTR | DESCRIPTION                             | DATE      | DWN | APVD |
|---|-----|---|-----------|-----|------|
| 3 |     | STRIKE THROUGH OBS PARTS. ECR-16-009583 | 08JUL2016 | AFK | LS   |
| 2 |     | ECR-13-007797                           | 07MAY2013 | KR  | KA   |

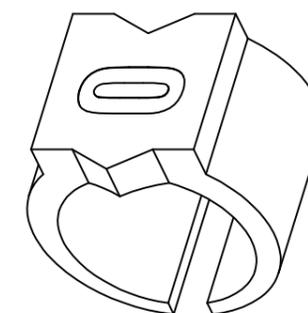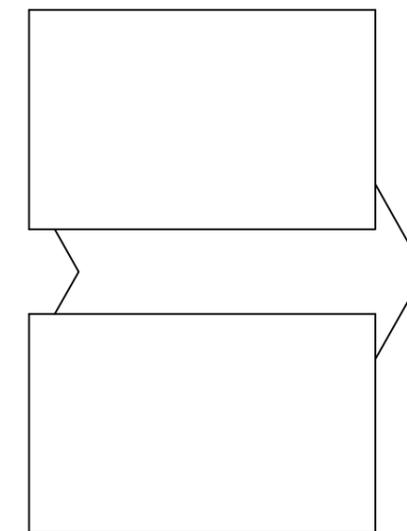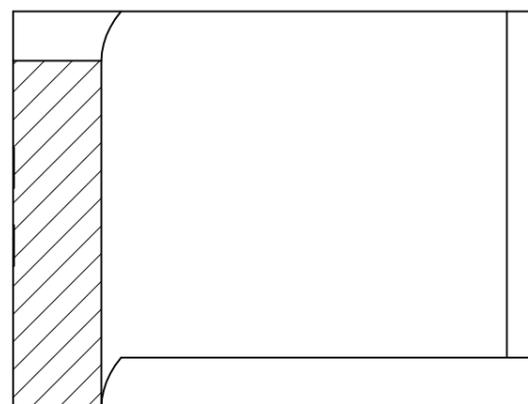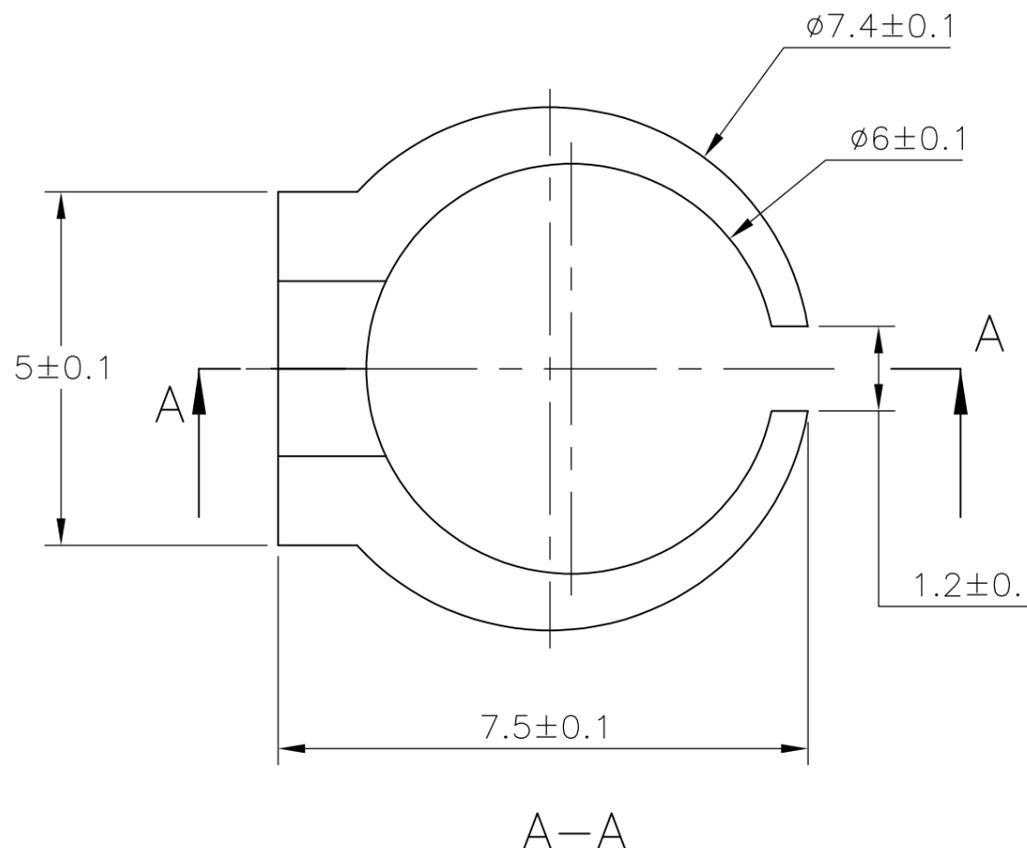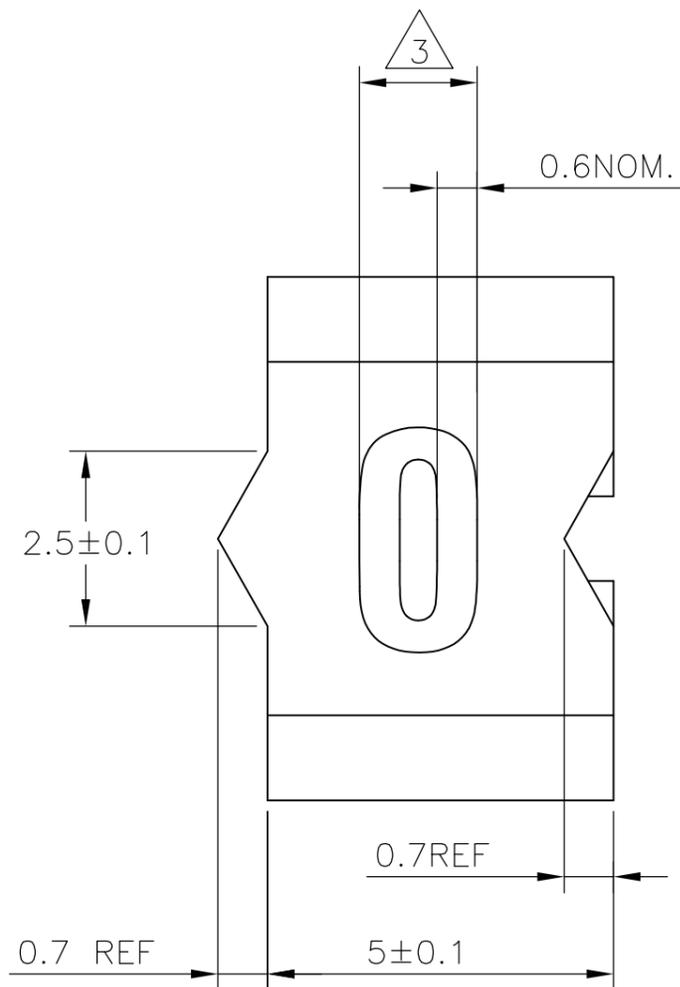

NOTES:

- 1 FOR PART NUMBER SEE SHEET 3 OF 3.
- 2 MARK SHOULD BE CENTRALLY POSITIONED ±0.1mm.
- 3 WIDTH OF MARK DEPENDS ON CHARACTER PRINTED

|  |  |                              |   |                 |                          |
|--|--|------------------------------|---|-----------------|--------------------------|
| THIS DRAWING IS A CONTROLLED DOCUMENT. |  | DWN RAGHAVENDRA K 22MAR2013  | <b>STE</b> TE Connectivity                          |                 |                          |
|  |  | CHK KEAN ALAN 22MAR2013      |   |                 |                          |
|  |  | APVD MARIO APPELLO 22MAR2013 | NAME SNAP-ON MARKER STB/STD SIZE 15 WITH APPLICATOR |                 |                          |
| DIMENSIONS: mm                         |  | PRODUCT SPEC                 | -   |                 |                          |
| TOLERANCES UNLESS OTHERWISE SPECIFIED: |  | APPLICATION SPEC             | -   |                 |                          |
| 0 PLC ± -                              |  | WEIGHT 0                     | SIZE A3   | CAGE CODE 00779 | DRAWING NO C-7-1768045-4 |
| 1 PLC ± -                              |  |                              | RESTRICTED TO                                       |                 | -                        |
| 2 PLC ± -                              |  |                              | SCALE NTS   |                 |                          |
| 3 PLC ± -                              |  |                              | SHEET 1 OF 3  |                 |                          |
| 4 PLC ± -                              |  |                              | REV 3   |                 |                          |
| ANGLES ± -                             |  |                              |   |                 |                          |
| FINISH -                               |  |                              |   |                 |                          |
| MATERIAL -                             |  |                              |   |                 |                          |
|  |  | CUSTOMER DRAWING             |   |                 |                          |

THIS DRAWING IS UNPUBLISHED.

RELEASED FOR PUBLICATION

ALL RIGHTS RESERVED.


© COPYRIGHT - By -

REVISIONS

| P | LTR | DESCRIPTION | DATE | DWN | APVD |
|---|-----|-------------|------|-----|------|
| - | -   | SEE SHEET 1 | -    | -   | -    |

23° REF.

A-A

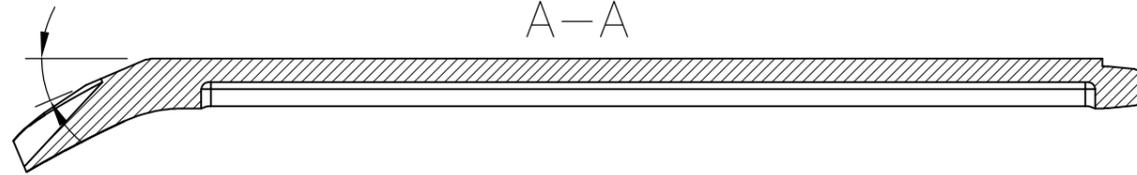

127±2

6.5 REF.

5±0.1

A



R1±0.1

R5±0.1

8.7±0.1

0.8±0.1

160±2

B

152.6° REF.

16 REF.

7 REF.

B-B

R1±0.05


1.3±0.1

2.8±0.1

6±0.25

15±0.5

5.5±0.5

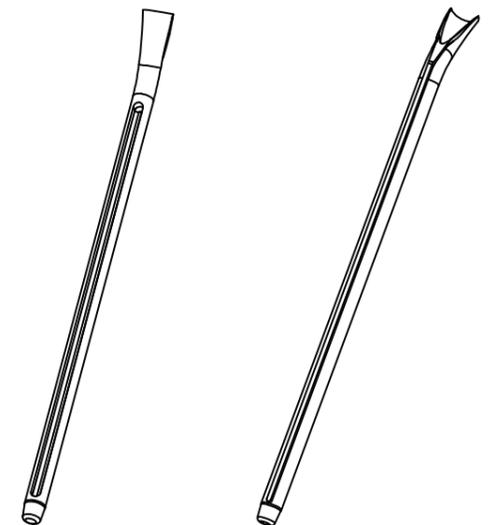

THIS DRAWING IS A CONTROLLED DOCUMENT.

DWN 22MAR2013 RAGHAVENDRA K

CHK 22MAR2013 KEAN ALAN

APVD 22MAR2013 MARIO APPELLO

PRODUCT SPEC

APPLICATION SPEC

WEIGHT -

CUSTOMER DRAWING



NAME SNAP-ON MARKER STB/STD SIZE 15 WITH APPLICATOR


SIZE CAGE CODE DRAWING NO RESTRICTED TO

A3 00779 C-7-1768045-4

SCALE NTS SHEET 2 of 3 REV 3

DIMENSIONS:

mm

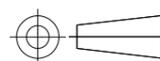

TOLERANCES UNLESS OTHERWISE SPECIFIED:

- 0 PLC ± -
- 1 PLC ± -
- 2 PLC ± -
- 3 PLC ± -
- 4 PLC ± -
- ANGLES ± -

MATERIAL -

FINISH -

THIS DRAWING IS UNPUBLISHED.

RELEASED FOR PUBLICATION

-. - .

REVISIONS

© COPYRIGHT - By -

ALL RIGHTS RESERVED.

| P | LTR | DESCRIPTION | DATE | DWN | APVD |
|---|-----|-------------|------|-----|------|
| - | -   | SEE SHEET 1 | -    | -   | -    |

| DESCRIPTION   | PART NO.    |
|---------------|-------------|
| STB15-0-0     | 6-1768039-0 |
| STB15-1-1     | 6-1768039-1 |
| STB15-1-2     | 2-1768413-1 |
| STB15-1-3     | 9-1768412-3 |
| STB15-1-5     | 6-1768039-2 |
| STB15-2-2     | 6-1768039-4 |
| STB15-2-5     | 6-1768039-5 |
| STB15-3-2     | 2-1768413-2 |
| STB15-3-3     | 6-1768039-7 |
| STB15-4-2     | 2-1768413-3 |
| STB15-5-2     | 2-1768413-4 |
| STB15-5-5     | 7-1768039-0 |
| STB15-6-6     | 7-1768039-2 |
| STB15-7-7     | 7-1768039-3 |
| STB15-8-8     | 7-1768039-6 |
| STB15-A-3     | 7-1768039-7 |
| STB15-A-5     | 7-1768039-8 |
| STB15-BLANK-0 | 8-1768039-0 |
| STB15-BLANK-1 | 8-1768039-1 |
| STB15-BLANK-2 | 8-1768039-2 |
| STB15-BLANK-3 | 8-1768039-3 |
| STB15-BLANK-5 | 8-1768039-4 |
| STB15-BLANK-6 | 8-1768039-5 |
| STB15-BLANK-7 | 8-1768039-6 |
| STB15-BLANK-8 | 8-1768039-7 |
| STB15-F-6     | 8-1768039-9 |
| STB15-H-2     | 9-1768039-0 |
| STB15-H-5     | 7-1768418-2 |
| STB15-L-5     | 9-1768039-2 |
| STB15-R-0     | 9-1768039-6 |
| STB15-R-5     | 9-1768039-8 |
| STB15-S-5     | 7-1768418-3 |

| DESCRIPTION            | PART NO.               |
|------------------------|------------------------|
| STB15-T-6              | 1768040-1              |
| STB15-V-6              | 1768040-3              |
| STD15-APPLICATOR       | 5-1768045-4            |
| STD15W-0               | 5-1768045-5            |
| STD15W-1               | 916500-000             |
| STD15W-2               | 631526-000             |
| STD15W-3               | 883382-000             |
| STD15W-4               | 924992-000             |
| STD15W-5               | 381396-000             |
| STD15W-6               | 545292-000             |
| STD15W-7               | 360170-000             |
| STD15W-8               | 075056-000             |
| STD15W-9               | 054712-000             |
| STD15W-A               | 755008-000             |
| <del>STD15W-A-LC</del> | <del>5-1768045-7</del> |
| STD15W-B               | 802902-000             |
| STD15W-BLANK           | 5-1768045-8            |
| STD15W-C               | 838714-000             |
| STD15W-D               | 629606-000             |
| <del>STD15W-D-LC</del> | <del>6-1768045-0</del> |
| STD15W-DOT             | 6-1768045-1            |
| STD15W-E               | 133110-000             |
| STD15W-EARTH           | 6-1768045-2            |
| STD15W-F               | 537002-000             |
| STD15W-G               | 685362-000             |
| STD15W-H               | 863976-000             |
| <del>STD15W-H-LC</del> | <del>6-1768045-2</del> |
| STD15W-I               | 913588-000             |
| STD15W-J               | 344640-000             |
| STD15W-K               | 501372-000             |
| STD15W-L               | 002648-000             |

| DESCRIPTION  | PART NO.    |
|--------------|-------------|
| STD15W-M     | 347828-000  |
| STD15W-MINUS | 6-1768045-9 |
| STD15W-N     | 612672-000  |
| STD15W-P     | 388482-000  |
| STD15W-PLUS  | 7-1768045-2 |
| STD15W-Q     | 621494-000  |
| STD15W-R     | 325234-000  |
| STD15W-S     | 544426-000  |
| STD15W-SLASH | 857128-000  |
| STD15W-T     | 845482-000  |
| STD15W-U     | 126270-000  |
| STD15W-V     | 907764-000  |
| STD15W-W     | 071812-000  |
| STD15W-X     | 362816-000  |
| STD15W-Y     | 578440-000  |
| STD15W-Z     | 063698-000  |
| STD15Y-0     | 7-1768045-4 |
| STD15Y-1     | 7-1768045-5 |
| STD15Y-2     | 7-1768045-6 |
| STD15Y-3     | 7-1768045-7 |
| STD15Y-4     | 7-1768045-8 |
| STD15Y-5     | 7-1768045-9 |
| STD15Y-6     | 8-1768045-0 |
| STD15Y-7     | 8-1768045-1 |
| STD15Y-8     | 8-1768045-2 |
| STD15Y-9     | 8-1768045-3 |
| STD15Y-A     | 8-1768045-4 |
| STD15Y-B     | 8-1768045-7 |
| STD15Y-BLANK | 8-1768045-8 |
| STD15Y-C     | 9-1768045-0 |

| DESCRIPTION  | PART NO.    |
|--------------|-------------|
| STD15Y-COLON | 9-1768045-1 |
| STD15Y-D     | 9-1768045-2 |
| STD15Y-DOT   | 9-1768045-4 |
| STD15Y-E     | 9-1768045-5 |
| STD15Y-EARTH | 9-1768045-6 |
| STD15Y-F     | 9-1768045-8 |
| STD15Y-G     | 1768046-1   |
| STD15Y-H     | 1768046-3   |
| STD15Y-I     | 1768046-5   |
| STD15Y-J     | 1768046-6   |
| STD15Y-K     | 1768046-7   |
| STD15Y-L     | 1768046-9   |
| STD15Y-M     | 1-1768046-1 |
| STD15Y-MINUS | 1-1768046-2 |
| STD15Y-N     | 1-1768046-4 |
| STD15Y-P     | 1-1768046-6 |
| STD15Y-PLUS  | 1-1768046-7 |
| STD15Y-Q     | 1-1768046-8 |
| STD15Y-R     | 1-1768046-9 |
| STD15Y-S     | 2-1768046-1 |
| STD15Y-SLASH | 2-1768046-2 |
| STD15Y-T     | 2-1768046-3 |
| STD15Y-U     | 2-1768046-4 |
| STD15Y-V     | 2-1768046-5 |
| STD15Y-W     | 2-1768046-6 |
| STD15Y-X     | 2-1768046-7 |
| STD15Y-Y     | 2-1768046-8 |
| STD15Y-Z     | 2-1768046-9 |



OBSOLETE PART

THIS DRAWING IS A CONTROLLED DOCUMENT.

DWN 22MAR2013 RAGHAVENDRA K

CHK 22MAR2013 KEAN ALAN

APVD 22MAR2013 MARIO APPELLO

PRODUCT SPEC

APPLICATION SPEC

WEIGHT -

CUSTOMER DRAWING



NAME SNAP-ON MARKER STB/STD SIZE 15 WITH APPLICATOR

SIZE A3 CAGE CODE 00779 DRAWING NO C-7-1768045-4 RESTRICTED TO -

SCALE NTS SHEET 3 OF 3 REV 3

# Mouser Electronics

Authorized Distributor

Click to View Pricing, Inventory, Delivery & Lifecycle Information:

[TE Connectivity:](#)

[STD15W-N](#)