
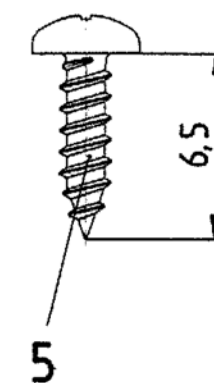
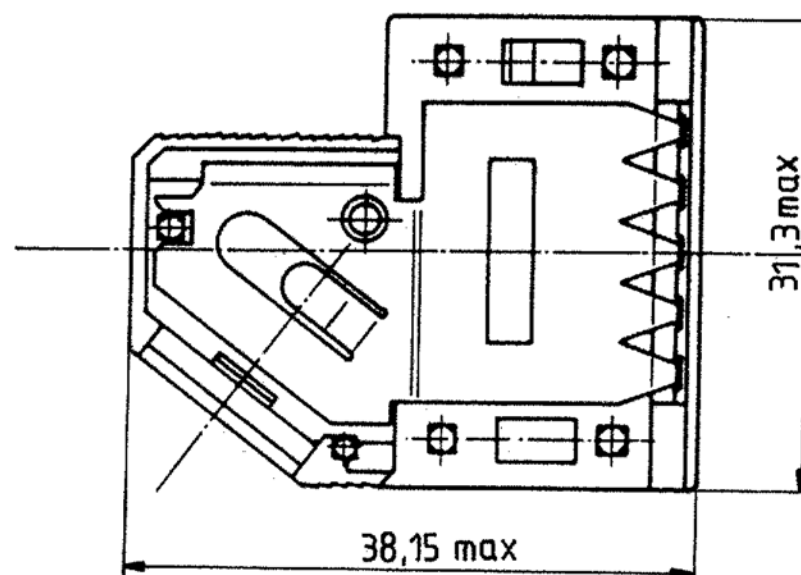
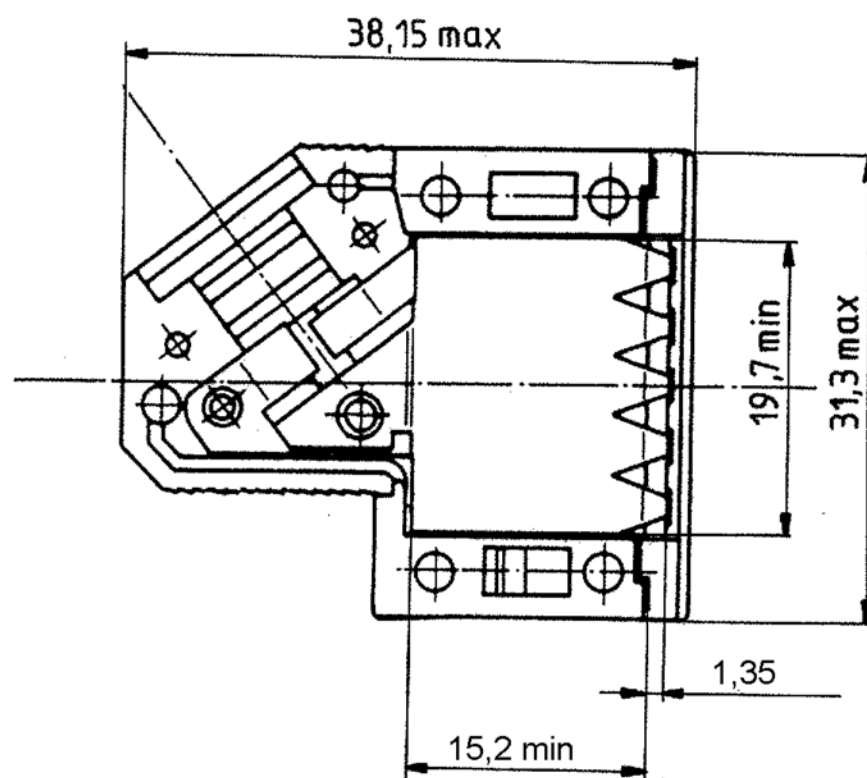
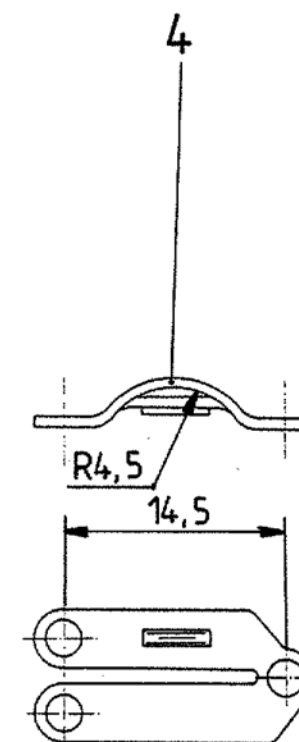
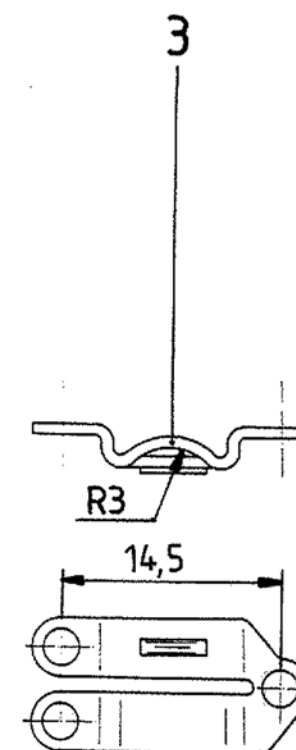
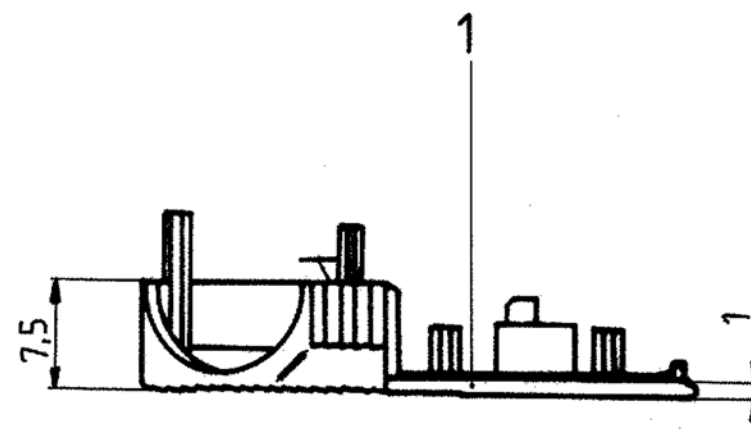


Sin nuestra expresa autorización, queda terminantemente prohibida la reproducción total o parcial de este documento, así como su uso indebido y/o su exhibición o comunicación a terceros. De los infractores se exigirá el correspondiente resarcimiento de daños y perjuicios. Se reserva todos los derechos para el caso de la concesión de patente de invención o el registro de Modelo Industrial.

Weitergabe sowie Vervielfältigung dieser Unterlage, Verwertung und Mitteilung ihres Inhalts ist nicht gestattet, soweit nicht ausdrücklich zugestanden. Zuwiderhandlungen verpflichten zu Schadenersatz. Alle Rechte für den Fall der Patenterteilung oder GM-Eintragung vorbehalten.

Copying of this document, and giving it to others and the use or communication of the contents thereof, are forbidden without express authority. Offenders are liable to the payment of damages. All rights are reserved in the event of the grant of a patent or the registration of a utility model or design.

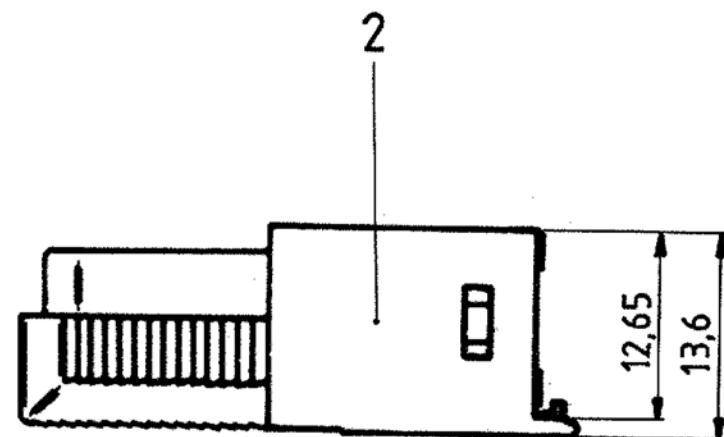

- 1 FOR PLASTIC PARTS (POS. 1 AND 2):  
 - LENGTHS: DIN 16901/130,  
 - ANGLES, FORMS: DIN 7168-m, R,  
 FOR METAL PARTS (POS. 3 AND 4): DIN 7168-m,  
 FOR SCREWS (POS. 5 AND 6): DIN 7981 F-H.

P/N 9 contacts version: V42254-A6000-G\*09

|   |   |                                                                |
|---|---|----------------------------------------------------------------|
|  TE Connectivity |   | Maßstab                                                        |
| Datum: 30.08.88<br>Bearb: De Petter<br>Gepr: PD Com P&SE<br>Norm:                                     |   | D-Sub housing<br>shielded 9 contacts                           |
| TOLERANCES UNLESS OTHERWISE SPECIFIED:                                                                |   | V42254-A6000-G***-*-27<br>customer drawing number: C 1393738-1 |
| D ECO-12-017358 22JAN13 CWR<br>C ECO-12-008266 28AUG12 CWR<br>Zust: Mitteilung Datum: Name:           | 1 | page 1+<br>of 6                                                |

Con questa espresión autolimitada queda formalmente prohibida la reproducción total o parcial de este documento, así como su uso indebido y/o su exhibición o comunicación a terceros. De los infractores se exigirá el correspondiente resarcimiento de daños y perjuicios. Se reserva todos los derechos para el caso de la concesión de patente de invención o el registro de Modelo Industrial.

Weitergabe sowie Verwertung dieses Unterlage, Verwertung und Mitteilung ihres Inhalts ist nicht gestattet, soweit nicht ausdrücklich zugestanden. Zuwiderhandlungen verpflichten zu Schadenersatz. Alle Rechte für den Fall der Patenterteilung oder G.M. Untertage vorbehalten.

Copying of this document and giving it to others and the use or communication of the contents thereof are forbidden without express authority. Offenders are liable to the payment of damages. All rights are reserved in the event of the grant of a patent or the registration of a utility model or design.

A

B

C

D

E

F

A









B

C

D

E

F

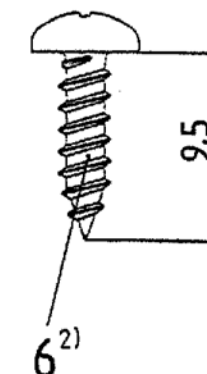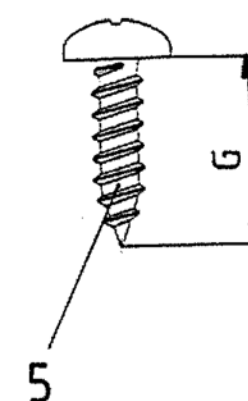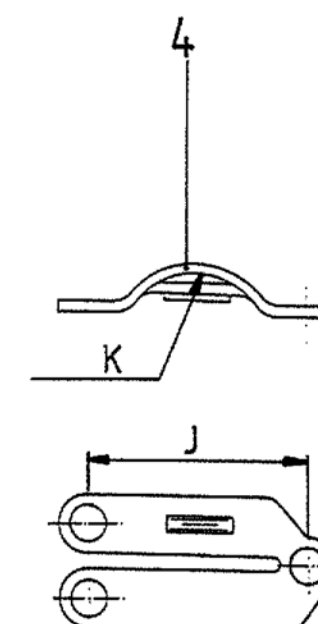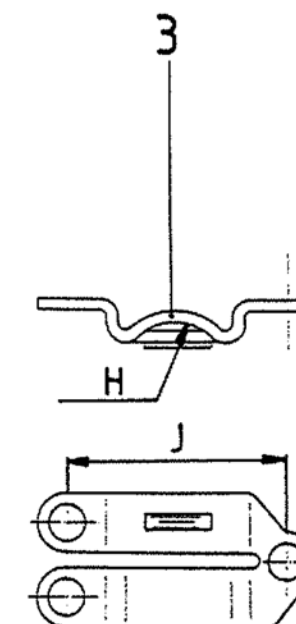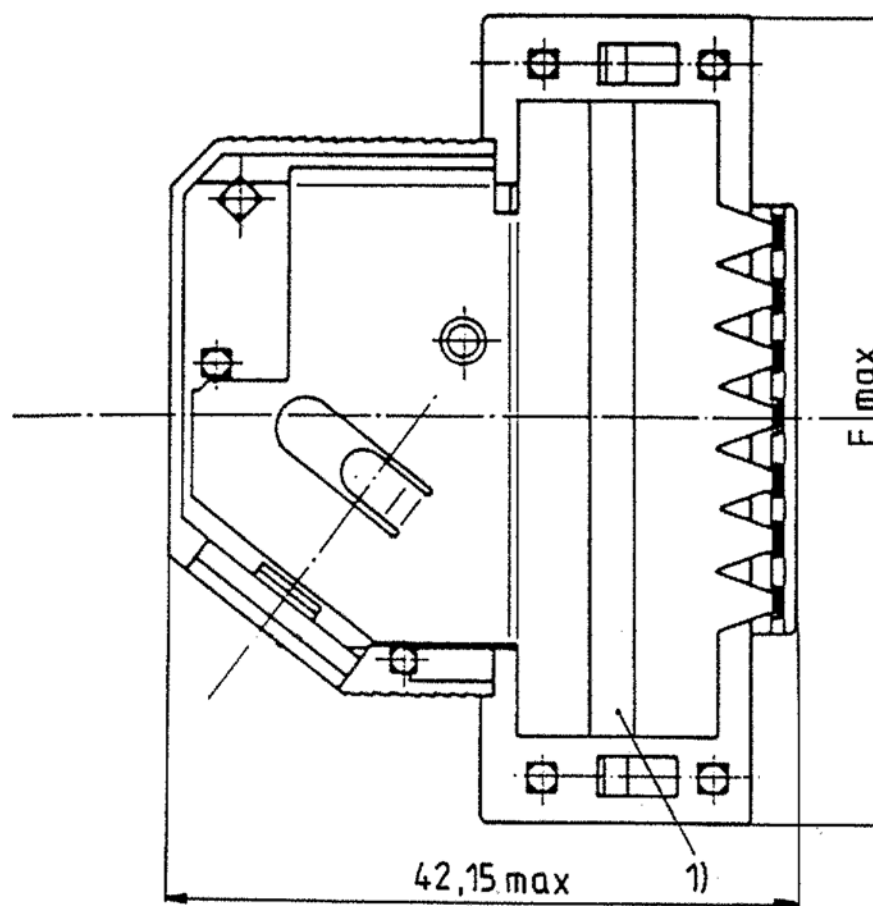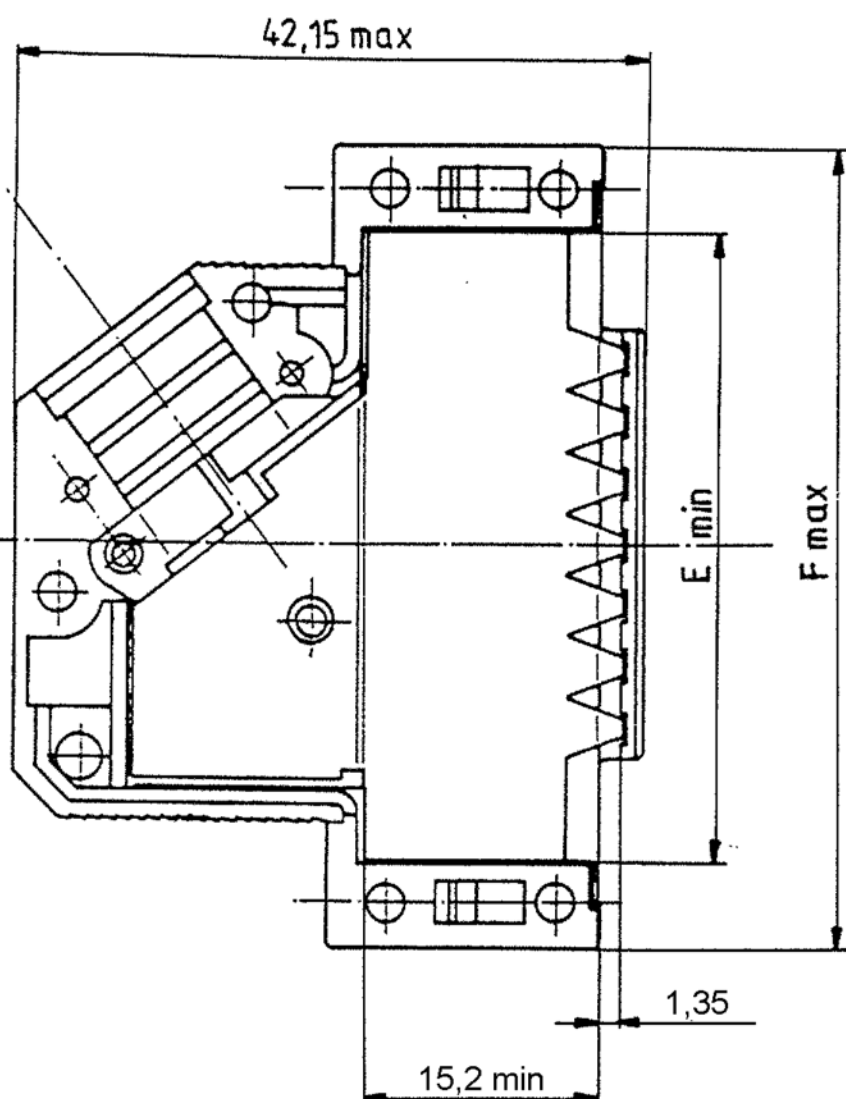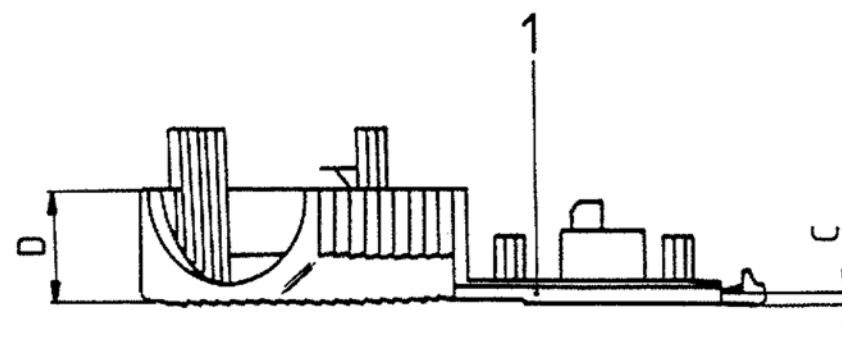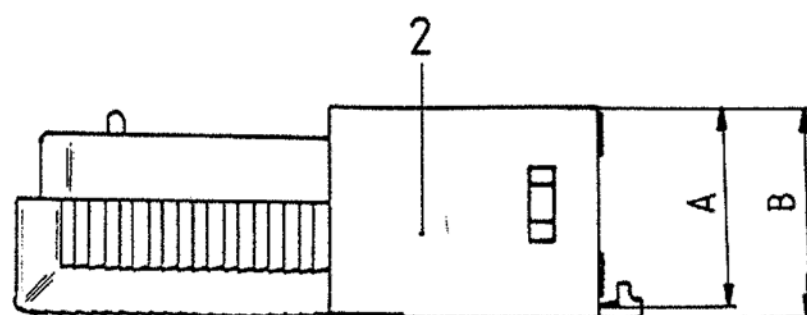

| housing       |                 | dimension |      |     |     |       |       |     |      |      |      |
|---------------|-----------------|-----------|------|-----|-----|-------|-------|-----|------|------|------|
| P/N           | No. of contacts | A         | B    | C   | D   | E     | F     | G   | H    | J    | K    |
| V42254-A6000- |                 |           |      |     |     |       |       |     |      |      |      |
| G × 15        | 15              |           |      |     |     | 28    | 39,62 |     | R3   | 14,5 | R4,5 |
| G × 25        | 25              | 13        | 14   | 1   | 7,5 | 41,8  | 53,52 | 6,5 | R4   | 16   | R5,5 |
| G × 37        | 37              |           |      |     |     | 58,25 | 69,8  |     |      |      |      |
| G × 50        | 50              | 16        | 17,5 | 1,5 | 9,5 | 55,78 | 67,41 | 9,5 | R5,5 | 20,6 | R7   |

2) only for the 37 contacts version

1) tape only for the 15 to 37 contacts versions  
drawn is the 25 contacts version

|               |            |                                                                   |      |                                      |  |
|---------------|------------|-------------------------------------------------------------------|------|--------------------------------------|--|
|               |            |                                                                   |      | Maßstab                              |  |
|               |            |                                                                   |      | TE Connectivity                      |  |
|               |            |                                                                   |      | D-Sub housing                        |  |
|               |            |                                                                   |      | shielded 15 to 50 contacts           |  |
|               |            | Datum: 30.08.88<br>Bearb: De Petter<br>Gepr: PD Com P&SE<br>Norm: |      | V42254-A6000-G***-27                 |  |
|               |            | TOLERANCES UNLESS OTHERWISE SPECIFIED:                            |      | customer drawing number: C 1393738-1 |  |
| D SEE SHEET 1 |            |                                                                   |      | page 2+                              |  |
| Zust          | Mitteilung | Datum                                                             | Name |                                      |  |

V 4 2 2 5 4 - A 6 0 0 \* - G \* \* \*

Housing type

G plastic housing, shielded

Marking and colour of the housing

1 TE-marking, grey

2 without marking, grey


3 TE-marking, black

4 without marking, black

|   | wire diameter |        |         |        |        | No. of contacts - housing size |                              |
|---|---------------|--------|---------|--------|--------|--------------------------------|------------------------------|
|   | 0             | 1      | 2       | 3      | 4      |                                |                              |
| Packaging   | set 1)        | 4-8    | 4-6     | 6-8    | 4-8    | 09                             | 9 contact - housing size 1   |
|   | 200 2)        | 5-10   | 5-8     | 8-10   | 5-10   | 15                             | 15 contacts - housing size 2 |
|   | 200 2)        | 5-11   | 5-8,5   | 8,5-1  | 5-11   | 25                             | 25 contacts - housing size 3 |
|   | 200 2)        | 6-11   | 6-8     | 10-11  | 6-11   | 37                             | 37 contacts - housing size 4 |
|   | 200 2)        | 9-14,5 | 12-14,5 | 9-14,5 | 9-14,5 | 50                             | 50 contacts - housing size 5 |
| 1) per set, in blister<br>- 9 and 15 contacts : 25<br>- 25, 37 and 50 contacts : 15<br>2) loose pieces, in cardboard : 200 |               |        |         |        |        |                                |                              |



TE Connectivity

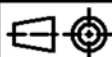

LOC DIMENSIONS  
GW IN MM

SCALE

WEIGHT

MATERIAL

DATE 30.08.88

NAME De Petter

DEP. PD Com P&SE

EC

TOLERANCE UNLESS  
SPECIFIED OTHERWISE

NAME

D-Sub Housing

shielded

DWG NO.

V42254-A6000-G\*\*\*-\*-27

SHT. 3+

D SEE SHEET 1

REV. CHANGE ORDER

DATE

APP.

customer drawing number: C 1393738-1

OF 6

THIS INFORMATION IS CONFIDENTIAL AND PROPRIETARY TO TYCO ELECTRONICS CORPORATION AND ITS WORLDWIDE SUBSIDIARIES AND AFFILIATES. IT MAY NOT BE DISCLOSED TO ANYONE, OTHER THAN TYCO ELECTRONICS PERSONNEL, WITHOUT WRITTEN AUTHORIZATION FROM TYCO ELECTRONICS CORPORATION, HARRISBURG, PENNSYLVANIA USA.

PROPRIETARY:

| 1                 | 2   | 3 | 4 | |
|---|
| A                 | <p>Active part numbers. Contact<br/>Tyco Electronics for<br/>other configuration availability</p> <table border="1" style="width:100%; border-collapse: collapse;"> <thead> <tr> <th style="width:50%;">Old Part Number</th> <th style="width:50%;">TE Part Number</th> </tr> </thead> <tbody> <tr><td>V42254-A6000-G109</td><td>1393738-1</td></tr> <tr><td>V42254-A6000-G115</td><td>1393738-2</td></tr> <tr><td>V42254-A6000-G125</td><td>1393738-3</td></tr> <tr><td>V42254-A6000-G137</td><td>1393738-4</td></tr> <tr><td>V42254-A6000-G150</td><td>1393738-5</td></tr> <tr><td>V42254-A6000-G209</td><td><del>1393738-6</del> OBSOLETE</td></tr> <tr><td>V42254-A6000-G309</td><td><del>1393738-7</del> OBSOLETE</td></tr> <tr><td>V42254-A6000-G315</td><td><del>1393738-8</del> OBSOLETE</td></tr> <tr><td>V42254-A6000-G325</td><td>1393738-9 SUPERSEDED BY 1393738-1</td></tr> <tr><td>V42254-A6001-G109</td><td>4-1393738-2 OBSOLETE</td></tr> <tr><td>V42254-A6001-G125</td><td>4-1393738-4 SUPERSEDED BY 6-1393738-1</td></tr> <tr><td>V42254-A6001-G309</td><td>4-1393738-5 SUPERSEDED BY 1-1393739-9</td></tr> <tr><td>V42254-A6001-G315</td><td>4-1393738-6 SUPERSEDED BY 6-1393738-7</td></tr> <tr><td>V42254-A6002-G109</td><td>5-1393738-0 OBSOLETE</td></tr> <tr><td>V42254-A6002-G125</td><td>5-1393738-2 SUPERSEDED BY 6-1393738-1</td></tr> <tr><td>V42254-A6003-G137</td><td>5-1393738-7 SUPERSEDED BY 6-1393738-2</td></tr> <tr><td>V42254-A6004-G109</td><td>5-1393738-9</td></tr> <tr><td>V42254-A6004-G115</td><td>6-1393738-0</td></tr> <tr><td>V42254-A6004-G125</td><td>6-1393738-1</td></tr> <tr><td>V42254-A6004-G137</td><td>6-1393738-2</td></tr> <tr><td>V42254-A6004-G150</td><td>6-1393738-3</td></tr> <tr><td>V42254-A6004-G209</td><td>6-1393738-4 SUPERSEDED BY 5-1393738-9</td></tr> <tr><td>V42254-A6004-G215</td><td>6-1393738-5 OBSOLETE</td></tr> <tr><td>V42254-A6004-G225</td><td>6-1393738-6 OBSOLETE</td></tr> <tr><td>V42254-A6004-G309</td><td>1-1393739-9 OBSOLETE</td></tr> <tr><td>V42254-A6004-G315</td><td>6-1393738-7 OBSOLETE</td></tr> <tr><td>V42254-A6004-G325</td><td>2-1393739-0 OBSOLETE</td></tr> <tr><td>V42254-A6004-G337</td><td>2-1393739-1 SUPERSEDED BY 6-1393738-2</td></tr> <tr><td>V42254-A6004-G350</td><td>2-1393739-2 SUPERSEDED BY 6-1393738-3</td></tr> <tr><td>V42254-A6004-G409</td><td>6-1393738-8 OBSOLETE</td></tr> <tr><td>V42254-A6004-G415</td><td>6-1393738-9 OBSOLETE</td></tr> <tr><td>V42254-A6004-G437</td><td>7-1393738-1 OBSOLETE</td></tr>
| C                 |   |   |   | D               | |
| E                 |   |   |   | F               | |

TE Connectivity

LOC

GW

DIMENSIONS IN MM

SCALE

MATERIAL

WEIGHT

|      |              |      |      |                                      |             |                        |                                      |      |
|------|--------------|------|------|--------------------------------------|-------------|------------------------|--------------------------------------|------|
|      |              |      |      | DATE                                 | 30.08.88    | NAME                   | <p>D-Sub Housing</p> <p>shielded</p> |      |
|      |              |      |      | NAME                                 | De Petter   |                        |                                      |      |
|      |              |      |      | DEP.                                 | PD Com P&SE |                        |                                      |      |
|      |              |      |      | EC                                   |             |                        |                                      |      |
|      |              |      |      | TOLERANCE UNLESS SPECIFIED OTHERWISE |             | DWG NO.                | SHT. 4+                              |      |
|      |              |      |      |                                      |             | V42254-A6000-G***-*-27 |                                      |      |
| D    | SEE SHEET 1. |      |      |                                      |             |                        |                                      |      |
| REV. | CHANGE ORDER | DATE | APP. | Customer Drawing: C 1393738-1        |             |                        |                                      | OF 6 |

1
2
3
4

THIS INFORMATION IS CONFIDENTIAL AND PROPRIETARY TO TYCO ELECTRONICS CORPORATION AND ITS WORLDWIDE SUBSIDIARIES AND AFFILIATES. IT MAY NOT BE DISCLOSED TO ANYONE, OTHER THAN TYCO ELECTRONICS PERSONNEL, WITHOUT WRITTEN AUTHORIZATION FROM TYCO ELECTRONICS CORPORATION, HARRISBURG, PENNSYLVANIA USA.

PROPRIETARY:

V 4 2 2 5 4 - A 6 1 \* \* - L 1

| Technical data |                                        |                                       |
|----------------|----------------------------------------|---------------------------------------|
|                | contact tube<br>outer diameter<br>±0.1 | for shield braiding<br>outer diameter |
| 04             | 4                                      | 2.0 to 2.7                            |
| 05             | 5                                      | 2.8 to 3.7                            |
| 06             | 6                                      | 3.8 to 4.7                            |
| 07             | 7                                      | 4.8 to 5.7                            |
| 08             | 8                                      | 5.8 to 6.7                            |
| 09             | 9                                      | 6.8 to 7.7                            |
| 10             | 10                                     | 7.8 to 8.7                            |
| 11             | 11                                     | 8.8 to 9.7                            |
| 12             | 12                                     | 9.8 to 10.7                           |
| 13             | 13                                     | 10.8 to 11.7                          |
| 14             | 14                                     | 11.8 to 12.7                          |
| 15             | 15                                     | 12.8 to 13.7                          |

Active part numbers. Contact  
Tyco Electronics for  
other configuration availability

| Old Part Number | TE Part<br>Number      |          |
|-----------------|------------------------|----------|
| V42254-A6104-L1 | 3-1393561-2            | OBSOLETE |
| V42254-A6105-L1 | 3-1393561-3            |          |
| V42254-A6106-L1 | 3-1393561-4            |          |
| V42254-A6107-L1 | 3-1393561-5            |          |
| V42254-A6108-L1 | 3-1393561-6            |          |
| V42254-A6109-L1 | 3-1393561-9            |          |
| V42254-A6110-L1 | 4-1393561-0            |          |
| V42254-A6111-L1 | <del>4-1393561-1</del> | OBSOLETE |
| V42254-A6112-L1 | 4-1393561-2            |          |
| V42254-A6113-L1 | 4-1393561-3            | OBSOLETE |
| V42254-A6114-L1 | 4-1393561-4            | OBSOLETE |
| V42254-A6115-L1 | 5-1393502-9            | OBSOLETE |

|   |  |  |  |   |  |                                           |  |              |  |
|---|--|--|--|---|--|-------------------------------------------|--|--------------|--|
| APPLICABLE SPEC.:                                                                                     |  |  |  | FINISH   |  |                                           |  |              |  |
|  TE Connectivity |  |  |  |  DIMENSIONS<br>IN MM |  | DIMENSIONS APPLY                          |  | PLATING      |  |
|   |  |  |  |   |  | SCALE                                     |  | WEIGHT       |  |
|  LOC<br>GW       |  |  |  | DATE 30.08.88                                                                                             |  | NAME                                      |  |              |  |
|   |  |  |  |   |  | D-Sub Housing                             |  |              |  |
| REV. SEE SHEET 1                                                                                      |  |  |  | NAME De Petter                                                                                            |  | accessories: contact tubes                |  |              |  |
|   |  |  |  |   |  | DWG NO. V42254-A6000-G***-*-27            |  |              |  |
| REV. CHANGE ORDER                                                                                     |  |  |  | DATE   |  | APP. customer drawing number: C 1393738-1 |  | SHT. 5+ OF 6 |  |

V 4 2 2 5 4 - A 6 2 \* \* - L \* \* \*

| Technical Data |       |                                |                      |
|----------------|-------|--------------------------------|----------------------|
|                |       | bushing inner diameter<br>±0.2 | cable outer diameter |
| 00             | 1) 2) | /                              | /                    |
| 05             | 3)    | 5                              | 4.2 to 4.9           |
| 06             | 3)    | 6                              | 5.0 to 5.9           |
| 07             | 3)    | 7                              | 6.0 to 6.9           |
| 08             | 3)    | 8                              | 7.0 to 7.9           |
| 09             | 3)    | 9                              | 8.0 to 8.9           |
| 10             | 2)    | 10                             | 9.0 to 9.9           |
| 11             | 2)    | 11                             | 10.0 to 10.9         |
| 12             | 4)    | 12                             | 11.0 to 11.9         |
| 13             | 4)    | 13                             | 12.0 to 12.9         |
| 14             | 4)    | 14                             | 13.0 to 13.9         |
| 15             | 4)    | 15                             | 14.0 to 14.9         |

|     | contacts | colour |
|-----|----------|--------|
| 1   | 9 to 37  | grey   |
| 50  | 50       | grey   |
| 100 | 9 to 37  | black  |
| 150 | 50       | black  |

Active part numbers. Contact Tyco Electronics for other configuration availability

| Old Part Number   | TE Part Number |          |
|-------------------|----------------|----------|
| V42254-A6200-L 1  | 4-1393561-5    | OBSOLETE |
| V42254-A6200-L 50 | 4-1393561-6    | OBSOLETE |
| V42254-A6200-L100 | 5-1393502-1    | OBSOLETE |
| V42254-A6200-L150 | 5-1393502-2    | OBSOLETE |
| V42254-A6205-L 1  | 4-1393561-7    |          |
| V42254-A6205-L100 | 4-1393561-8    |          |
| V42254-A6206-L 1  | 4-1393561-9    |          |
| V42254-A6206-L100 | 5-1393561-0    |          |
| V42254-A6207-L 1  | 5-1393561-1    |          |
| V42254-A6207-L100 | 5-1393561-4    | OBSOLETE |
| V42254-A6208-L 1  | 5-1393561-5    |          |
| V42254-A6208-L100 | 5-1393561-6    | OBSOLETE |
| V42254-A6209-L 1  | 5-1393561-7    |          |
| V42254-A6209-L100 | 5-1393561-8    |          |
| V42254-A6210-L 1  | 5-1393561-9    |          |
| V42254-A6210-L 50 | 6-1393561-0    | OBSOLETE |
| V42254-A6210-L100 | 6-1393561-1    | OBSOLETE |
| V42254-A6210-L150 | 5-1393502-3    | OBSOLETE |
| V42254-A6211-L 1  | 6-1393561-2    |          |
| V42254-A6211-L 50 | 6-1393561-3    | OBSOLETE |
| V42254-A6211-L100 | 5-1393502-4    | OBSOLETE |
| V42254-A6211-L150 | 5-1393502-5    | OBSOLETE |
| V42254-A6212-L 50 | 6-1393561-4    | OBSOLETE |
| V42254-A6212-L150 | 5-1393502-6    | OBSOLETE |
| V42254-A6213-L 50 | 6-1393561-5    | OBSOLETE |
| V42254-A6213-L150 | 5-1393502-7    | OBSOLETE |
| V42254-A6214-L 50 | 6-1393561-6    | OBSOLETE |
| V42254-A6214-L150 | 5-1393502-8    | OBSOLETE |
| V42254-A6215-L 50 | 8-1393501-5    | OBSOLETE |
| V42254-A6215-L150 | 6-1393561-7    | OBSOLETE |

- 4) only for 50 contacts  
3) only for 9 to 37 contacts  
2) for 9 to 50 contacts  
1) Blank bushing

|   |  |  |  |                                                      |  |         |  |
|---|--|--|--|------------------------------------------------------|--|---------|--|
| APPLICABLE SPEC.                                                                                       |  |  |  | FINISH                                               |  |         |  |
|  TE Connectivity  |  |  |  | DIMENSIONS APPLY                                     |  | PLATING |  |
|   |  |  |  | SCALE                                                |  | WEIGHT  |  |
|  DIMENSIONS IN MM |  |  |  | MATERIAL                                             |  |         |  |
| DATE 30.08.88<br>NAME De Petter<br>DEP. PD Com P&SE<br>EC<br>TOLERANCE UNLESS SPECIFIED OTHERWISE      |  |  |  | NAME<br>D-Sub Housing<br>accessories: cable bushings |  |         |  |
| D SEE SHEET 1<br>REV. CHANGE ORDER<br>DATE<br>APP.                                                     |  |  |  | DWG NO.<br>V42254-A6000-G****-27<br>SHT. 6 OF 6      |  |         |  |
| customer drawing number: C 1393738-1                                                                   |  |  |  |                                                      |  |         |  |

# Mouser Electronics

Authorized Distributor

Click to View Pricing, Inventory, Delivery & Lifecycle Information:

[TE Connectivity:](#)

[1393738-4](#)